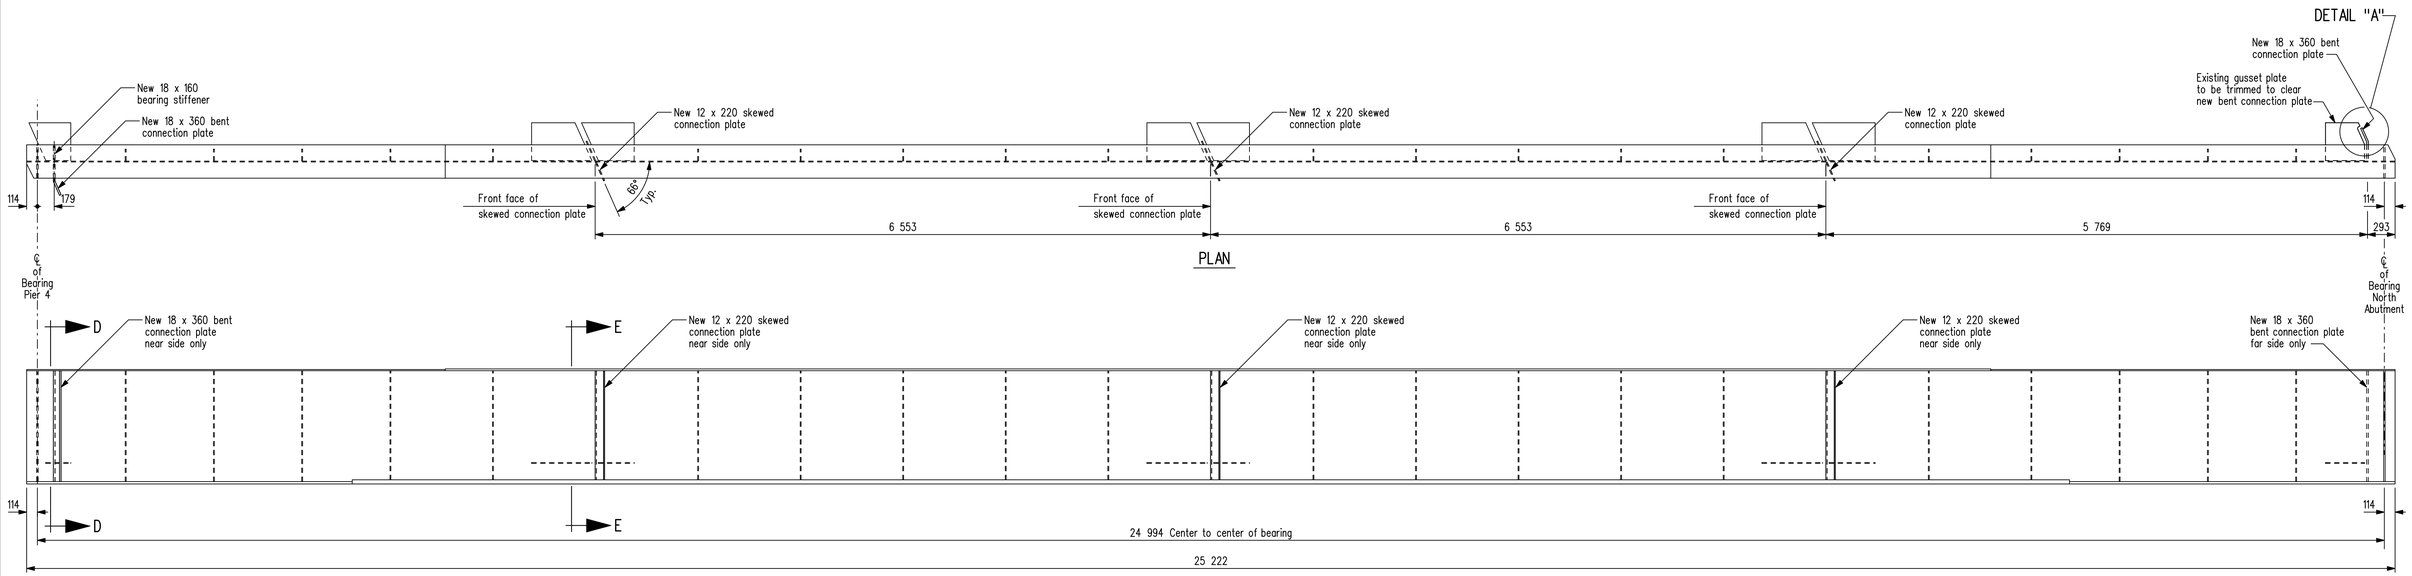

PIER 4 TO NORTH ABUTMENT

Showing proposed modifications to existing girder Mk. "G9".

NOTES:

1. For SECTIONS D-D & E-E see Sheet No. 21.
2. For DETAIL "A" see Sheet No. 21.

REVISIONS		
10/03/04	J.J.	As built
DATE	BY	DESCRIPTION

PROVINCE OF MANITOBA
Original signed by
M. B. CHISLETT
09/04/20
REGISTERED PROFESSIONAL ENGINEER

MODIFICATIONS TO EXISTING GIRDER Mk. "G9"

RECONSTRUCTION AND STRENGTHENING OF EXISTING BRIDGE
OVER ASSINIBOINE RIVER - CONTRACT ONE
ON P.T.H. No. 100 IN R.L.'S 72, 73 & 94
PARISH OF ST. CHARLES

CITY OF WINNIPEG

Manitoba
Infrastructure and Transportation
Water Control & Structures

RELEASED FOR CONSTRUCTION
BY:
Original signed by
Ruth J. Eden
09/05/01
DIRECTOR DATE
STRUCTURES, DESIGN AND CONSTRUCTION BRANCH

DESIGN	BY: M.B.C.	SCALE: 1:30	SHEET No. 24
	CHECKED: M.W.H.		
DETAILS	BY: D.P.W.		SITE No. 2924-00
	CHECKED: M.B.C.		

...\Contract_1\292400rehab.dgn 2010-03-04 3:13:07 PM