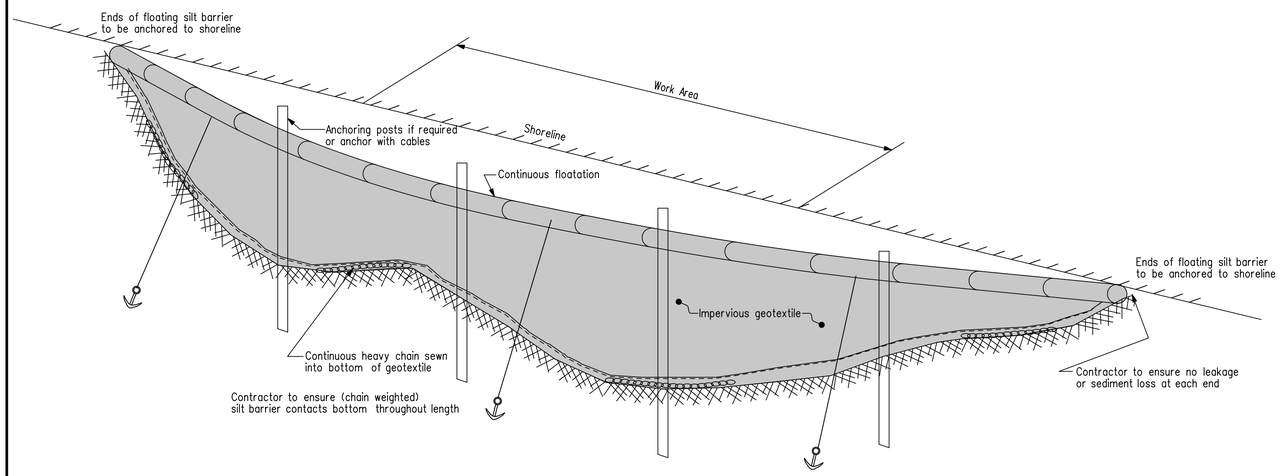

FLOATING SILT BARRIER

Shall be pre-manufactured to suit site conditions
Not to scale

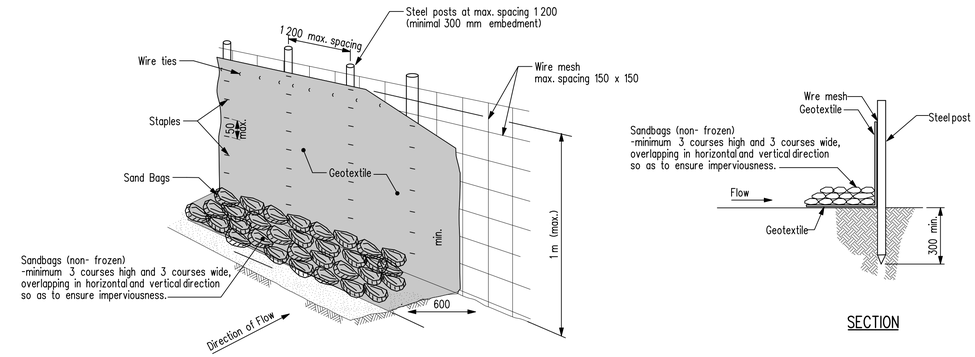

SECTION

REINFORCED SILT BARRIER DETAIL (FROZEN GROUND CONDITIONS)

Not to Scale

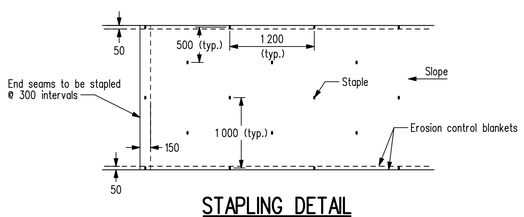

STAPLING DETAIL

Scale 1:40

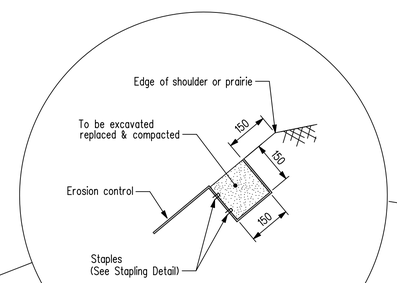

ANCHORING AT TOP OF GRADE OR BACK SLOPE

Scale 1:10

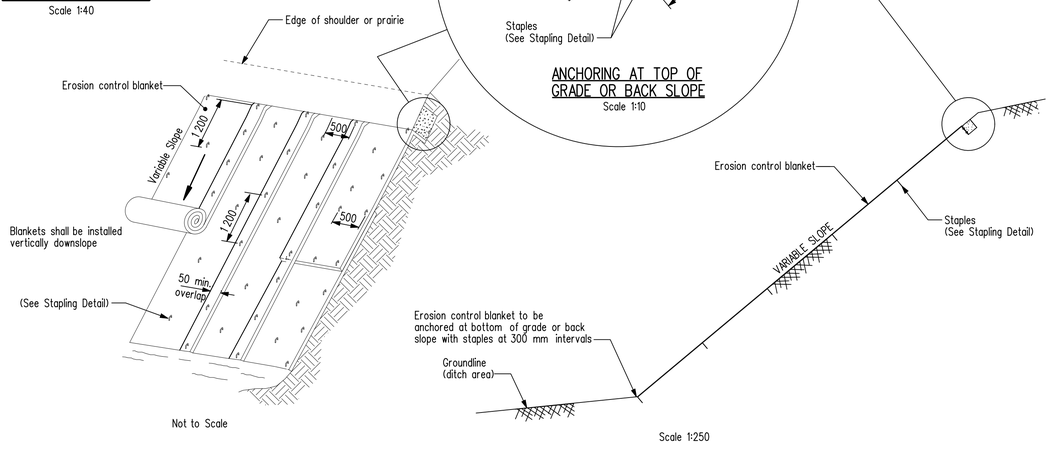

Not to Scale

Scale 1:250

DETAIL "A"

Erosion control blanket on grade and back slope
Scale As Shown

NOTES:

1. Slope surface shall be free of rocks, clods, sticks and grass. Blankets shall have good soil contact.
2. Lay blankets loosely and stake or staple to maintain direct contact with the soil. DO NOT STRETCH.
3. Topsoil and seed shall be placed prior to placing blanket.

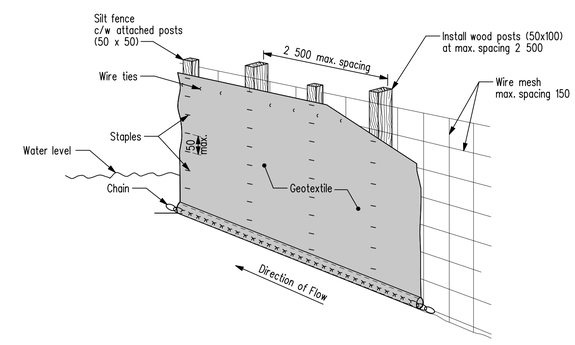

CHAINED REINFORCED SILT BARRIER DETAIL

Not to Scale

REVISIONS		
09/04/20	N.S.G.	As built
DATE	BY	DESCRIPTION

PROVINCE OF MANITOBA
Original signed by
N.S. GONZALEZ
Member
20774
09/04/20
REGISTERED PROFESSIONAL ENGINEER

SITE AND EROSION CONTROL DETAILS

RECONSTRUCTION AND STRENGTHENING OF EXISTING BRIDGE
OVER ASSINIBOINE RIVER - CONTRACT ONE
ON P.T.H. No. 100 IN R.L.'S 72, 73 & 94
PARISH OF ST. CHARLES

CITY OF WINNIPEG

Manitoba
Infrastructure and Transportation
Water Control & Structures

RELEASED FOR CONSTRUCTION
BY:
Original signed by
Ruth J. Eden
09/05/01

DIRECTOR — DATE
STRUCTURES, DESIGN AND CONSTRUCTION BRANCH

DESIGN	BY: N.G.	SCALE: As shown	SHEET No. 38
	CHECKED: N.G.		
DETAILS	BY: N.J.		SITE No. 2924-00
	CHECKED: N.G.		

...\292400_Sediment & Erosion Control.dgn 2010-03-04 3:31:44 PM