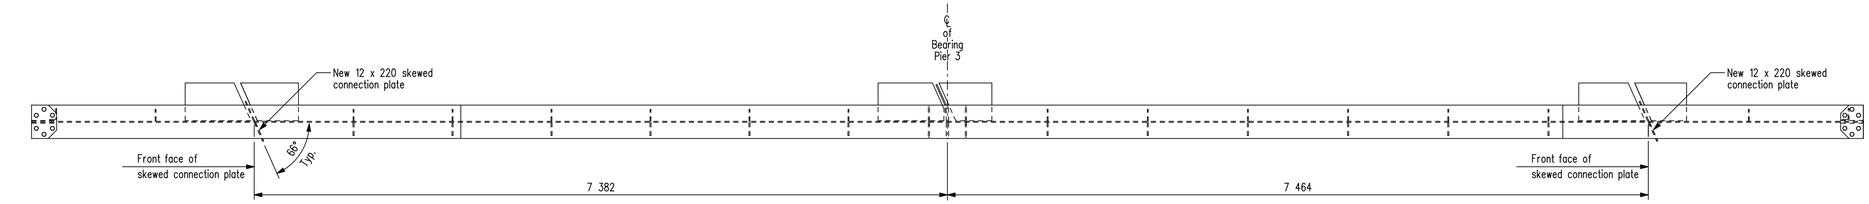

PLAN

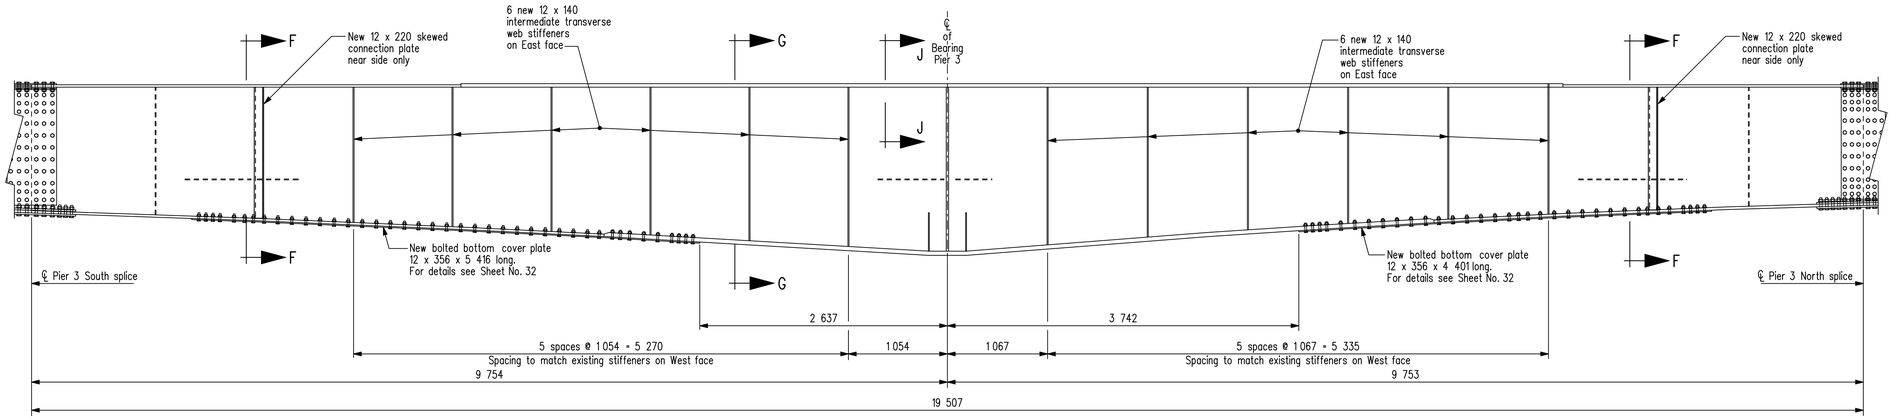

ELEVATION

PIER 3 SOUTH SPLICE TO PIER 3 NORTH SPLICE

Showing proposed modifications to existing girder Mk. "G9".

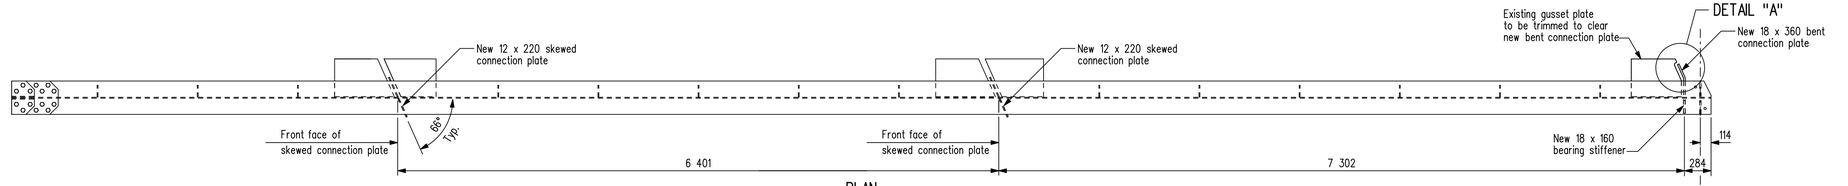

PLAN

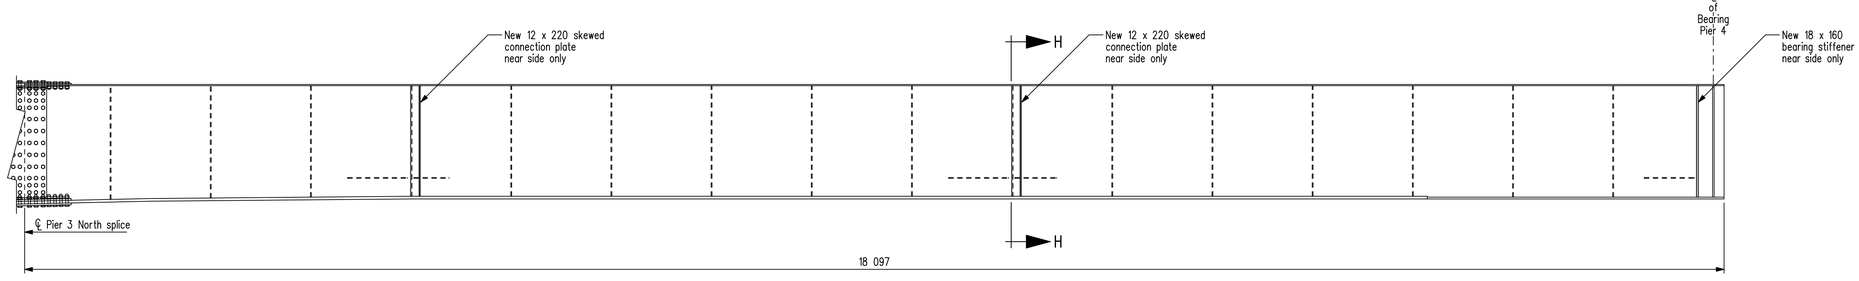

ELEVATION

PIER 3 NORTH SPLICE TO PIER 4

Showing proposed modifications to existing girder Mk. "G9".

NOTE:

1. For SECTIONS F-F, G-G, H-H & PART SECTION J-J see Sheet No. 22.
2. For DETAIL "A" see Sheet No. 21.

REVISIONS		
10/03/04	J.J.	As built
DATE	BY	DESCRIPTION

PROVINCE OF MANITOBA
Original signed by
M. B. CHISLETT
09/04/20
REGISTERED PROFESSIONAL ENGINEER

MODIFICATIONS TO EXISTING GIRDER Mk. "G9"

RECONSTRUCTION AND STRENGTHENING OF EXISTING BRIDGE
OVER ASSINIBOINE RIVER - CONTRACT ONE
ON P.T.H. No. 100 IN R.L.'S 72, 73 & 94
PARISH OF ST. CHARLES

CITY OF WINNIPEG

Manitoba
Infrastructure and Transportation
Water Control & Structures

RELEASED FOR CONSTRUCTION BY:
Original signed by
Ruth J. Eden
09/05/01
DIRECTOR — DATE
STRUCTURES, DESIGN AND CONSTRUCTION BRANCH

DESIGN	BY: M.B.C.	
	CHECKED: M.W.H.	
DETAILS	BY: D.P.W.	
	CHECKED: M.B.C.	

SCALE: 1 : 30
SHEET No. 23
SITE No. 2924-00